


METRIC DISTANCES SHOWN ON THIS PLAN ARE IN METRES AND CAN BE CONVERTED TO FEET BY DIVIDING BY 0.3048.


SURVEYOR'S REAL PROPERTY REPORT
PART 1
 PLAN OF SURVEY OF
ALL OF LOT 90
WEST SIDE OF HIGH STREET
PART OF LOT 65
EAST SIDE OF HIGH STREET
PART OF HIGH STREET
REGISTERED PLAN 115
ALL OF LOTS 115 TO 120, BOTH INCLUSIVE
PART OF LOT 121
ALL OF BOB STREET
ROBERT ROSS UNREGISTERED PLAN
PART OF ELLEN STREET
 (CLOSED BY BY-LAW No. 2005-115, INST. No. SC450705)
REGISTERED PLAN 22
EAST PART OF LOT 24 AND
EAST PART OF BROKEN LOT 25
CONCESSION 5
 (GEOGRAPHIC TOWNSHIP OF VESPREA)
CITY OF BARRIE
COUNTY OF SIMCOE
 SCALE 1:300

SURVEYOR'S REAL PROPERTY REPORT
PART 2
 THIS PLAN MUST BE READ WITH SURVEYOR'S REAL PROPERTY REPORT DATED JULY 31, 2019.

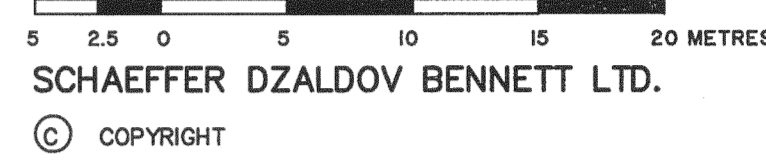

SCHAEFFER DZALDOV BENNETT LTD.
 © COPYRIGHT

SIMCOE STANDARD CONDOMINIUM PLAN No. 259
 CONDO BLOCK 59259

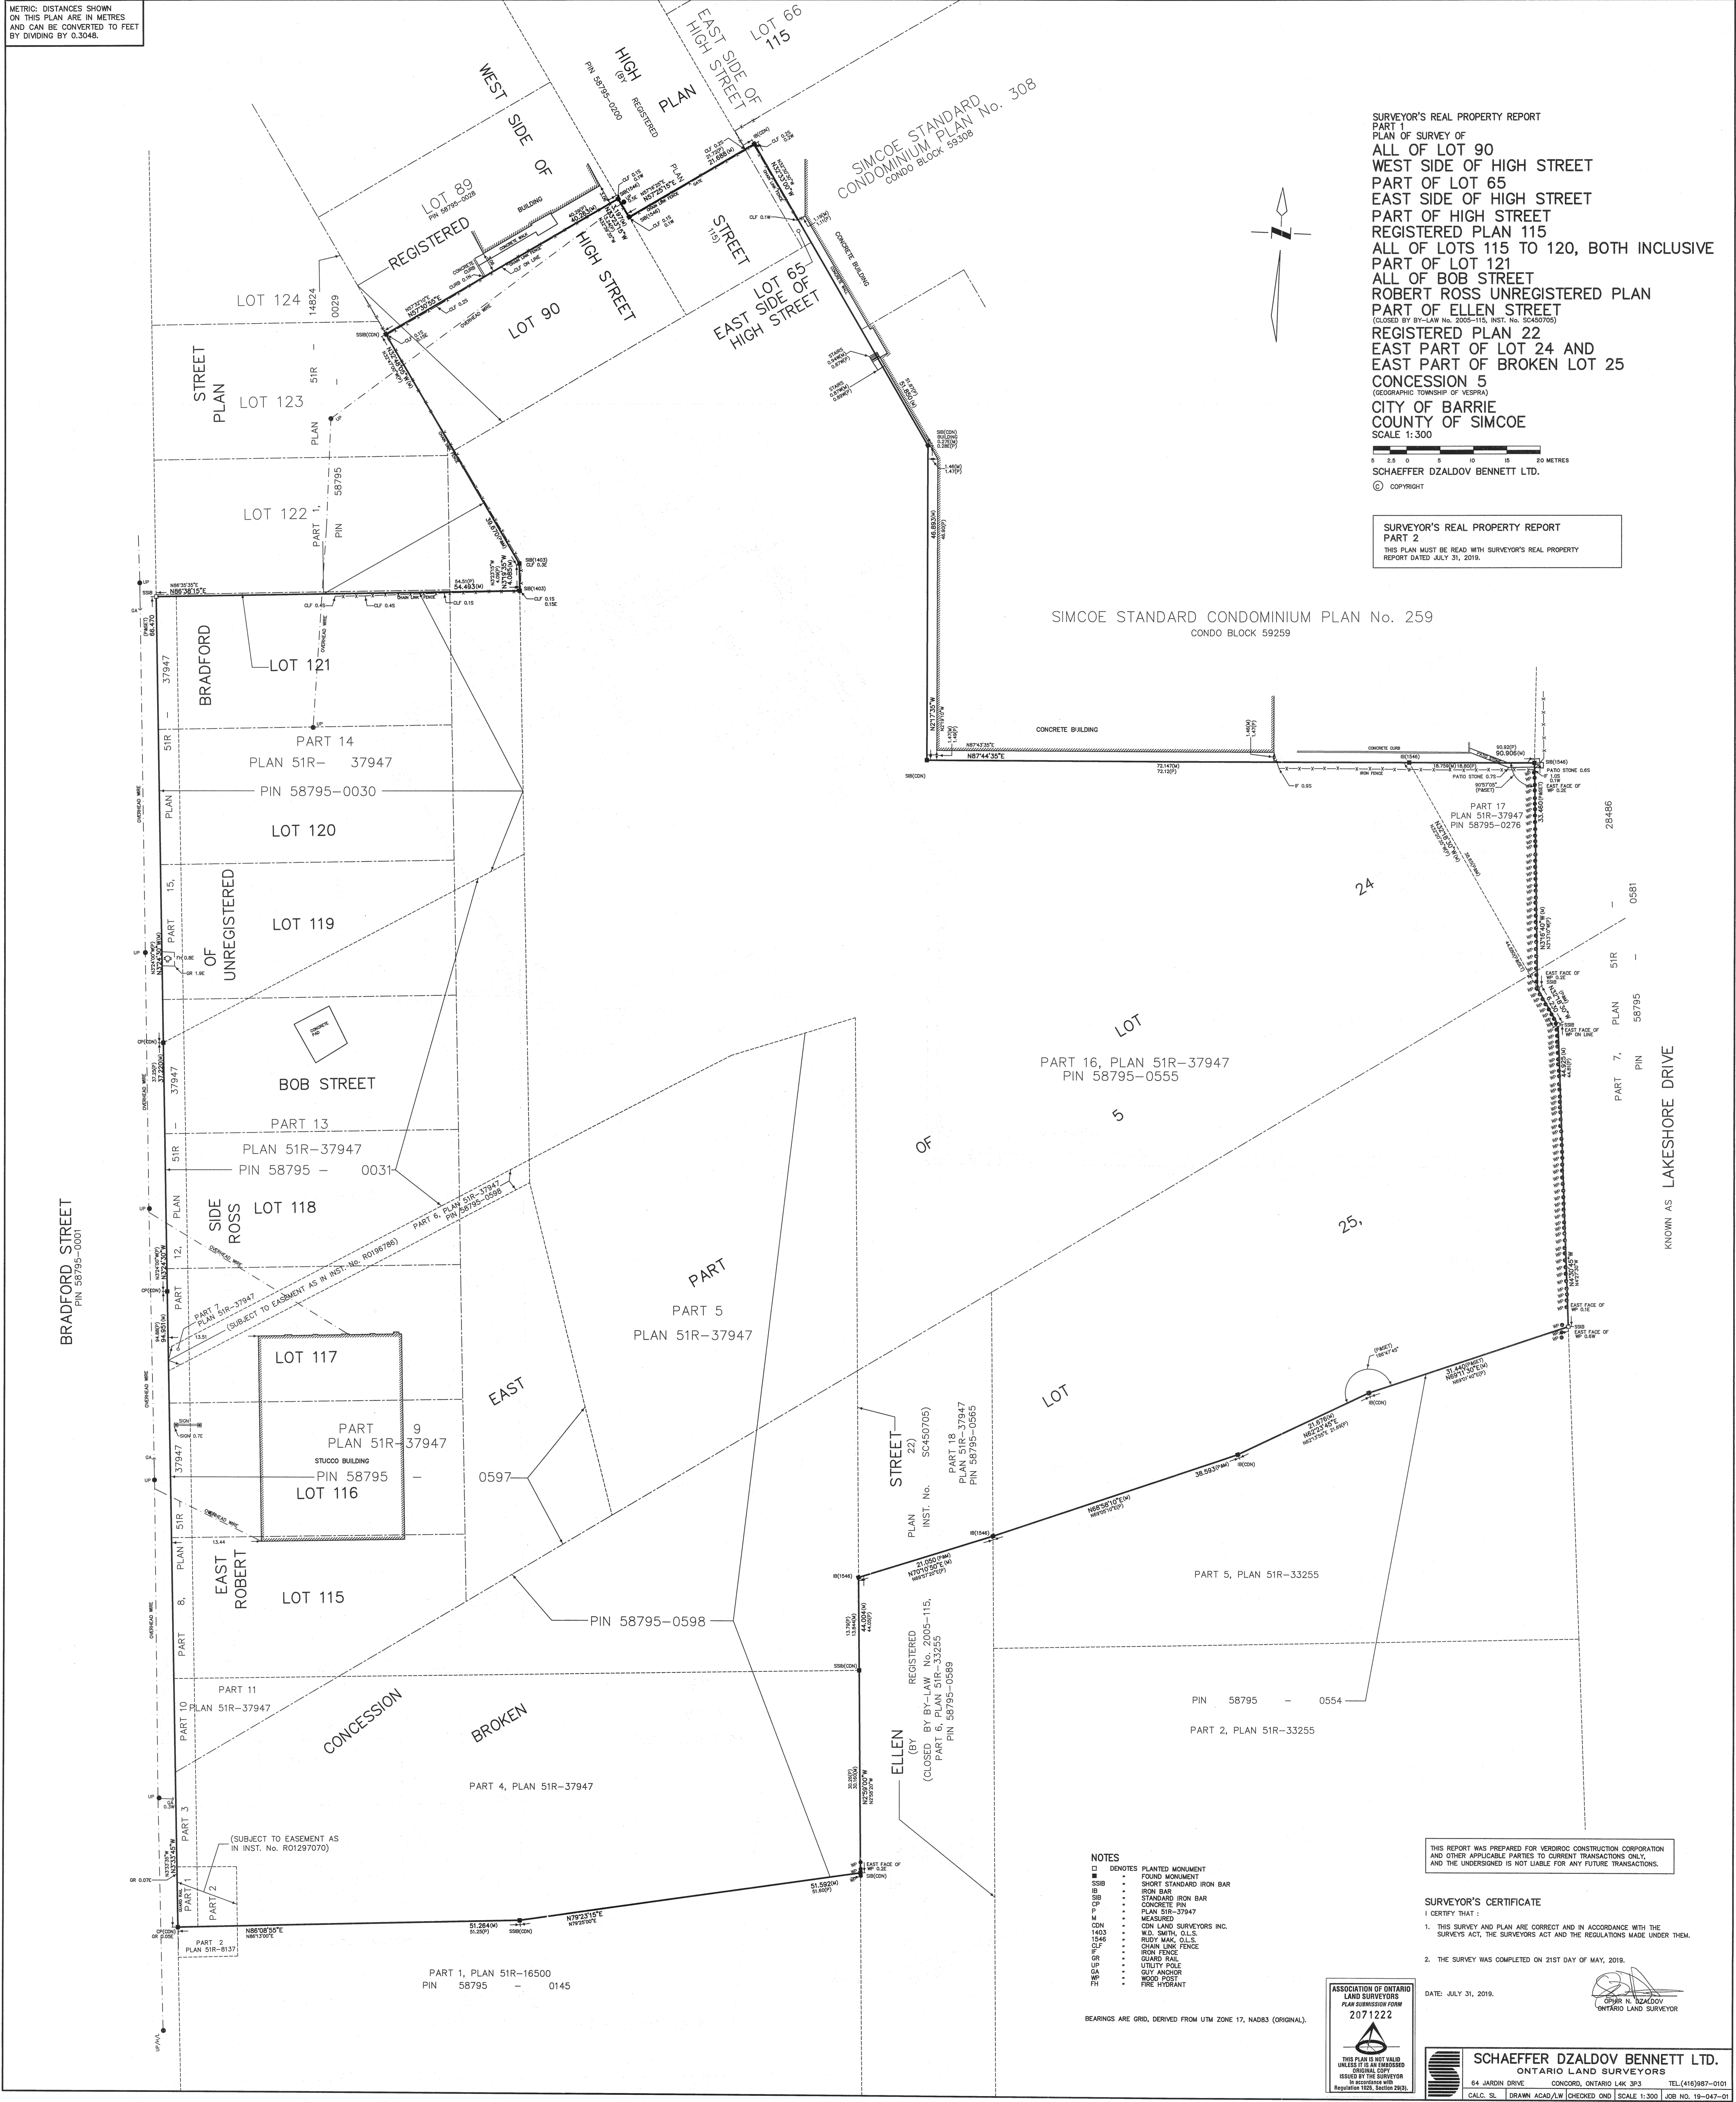

- NOTES**
- DENOTES PLANTED MONUMENT
 - FOUND MONUMENT
 - SSB SHORT STANDARD IRON BAR
 - SB IRON BAR
 - SB STANDARD IRON BAR
 - CP CONCRETE PIN
 - P PLAN 51R-37947
 - M MEASURED
 - CON CON LAND SURVEYORS INC.
 - 1403 W.D. SMITH, O.L.S.
 - 1546 RUDY HANK, O.L.S.
 - CLF CHAIN LINK FENCE
 - GR GUARD RAIL
 - GA UTILITY POLE
 - CA GUY ANCHOR
 - PH WOOD POST
 - FI FIRE HYDRANT

THIS REPORT WAS PREPARED FOR VERIDOR CONSTRUCTION CORPORATION AND OTHER APPLICABLE PARTIES TO CURRENT TRANSACTIONS ONLY, AND THE UNDERSIGNED IS NOT LIABLE FOR ANY FUTURE TRANSACTIONS.

SURVEYOR'S CERTIFICATE
 I CERTIFY THAT:
 1. THIS SURVEY AND PLAN ARE CORRECT AND IN ACCORDANCE WITH THE SURVEYS ACT, THE SURVEYORS ACT AND THE REGULATIONS MADE UNDER THEM.
 2. THE SURVEY WAS COMPLETED ON 21ST DAY OF MAY, 2019.

DATE: JULY 31, 2019.

ASSOCIATION OF ONTARIO LAND SURVEYORS
 PLAN SUBMISSION FORM
 2071222

SCHAEFFER DZALDOV BENNETT LTD.
 ONTARIO LAND SURVEYORS
 64 JARDIN DRIVE CONCORD, ONTARIO L4K 3P3 TEL: (416) 887-0101
 CALC. SL. DRAWN ACAD/LW CHECKED OND SCALE 1:300 JOB NO. 19-047-01

BEARINGS ARE GRID, DERIVED FROM UTM ZONE 17, NAD83 (ORIGINAL).